## **ELECTRICAL NOTES:**

- I. ALL ELECTRICAL WORK SHALL BE IN ACCORDANCE WITH THE NATIONAL ELECTRICAL CODE AND ALL APPLICABLE LOCAL CODES.
- 2. COORDINATE ELECTRICAL SERVICE W/FLORIDA POWER AND LIGHT COMPANY.
- ELECTRICAL INSTALLATION DESIGN OF THIS PLAN IN IN COMPLIANCE AS SET FORTH BY STATE OF FLORIDA STATUTES MODEL ENERGY EFFICIENCY CODES.
   THE CONTRACTOR WILL EXAMINE THE JOB SITE AND DETERMINE FOR HIMSELF PRIOR TO SUBMISSION OF BID
- EXISTING CONDITIONS.
- 5. ALL ELECTRICAL WORK SHALL BE PERFORMED BY A LICENSED ELECTRICAL CONTRACTOR. IT WILL BE HIS RESPONSIBILITY TO SECURE AND PAY FOR ANY PERMITS, CERTIFICATES OF INSPECTION, AS REQUIRED.
- 6. SUBSTITUTE MATERIALS EQUIPMENT OR METHODS SHALL NOT BE MADE WITHOUT APPROVAL OF THE ENGINEER. IF THE USE OF A SUBSTITUTE REQUIRES ANY CHANGE IN WORK. THE NECESSARY FOR SUCH CHANGE WILL BE BROUGHT TO THE ATTENTION OF THE ENGINEER. AND IF APPROVED, SHALL BE MADE AT NO COST TO THE OWNER.
- 7. CLEAN UP SUCH TRASH AND DEBRIS GENERATED BY THE WORK AND LEAVE COMPLETED WORK IN A CLEAN, UNDAMAGED, AND FINISHED CONDITION READY TO RECEIVE WITHOUT FURTHER PREPARATION, UNLESS SO SPECIFIED IN OTHER SECTIONS, ANY ADJACENT OR ABUTTING WORK TO BE PERFORMED BY OTHERS.
- 8. MATERIALS, APPLIANCES, DEVICES AND EQUIPMENT SHALL MEET WITH THE REQUIREMENTS OF UNDERWRITERS' LABORATORIES AND SHALL BE NEW AND THE LATEST STANDARD PRODUCTS OF MANUFACTURERS REGULARLY ENGAGED IN THE PRODUCTION OF THE ITEM, UNLESS OTHERWISE INDICATED. LIKE ITEMS SHALL BE THE PRODUCT OF A SINGLE MANUFACTURER.
- 9. ALL CONDUCTORS SHALL BE COPPER AND RUN IN CONDUIT. WIRE SIZE SHALL BE THWN UNLESS OTHERWISE NOTED
- ON PLANS. PROVIDE GROUND CONDUCTOR PER NEC 250-122.

  10. LOCATION OF OUTLETS IN ELECTRICAL DRAWINGS IS DIAGRAMMATIC. CHECK MANUFACTURER'S DRAWING FOR EXACT
- LOCATION OF OUTLETS.

  II. CIRCUIT NUMBERS SHOWN ARE FOR CALCULATION PURPOSES ONLY. ACTUAL CIRCUITING MAY VARY ACCORDING TO
- NEC AND FBC PROVIDE PANEL SCHEDULE AFTER COMPLETION.

  12. APPLIANCES LOAD ARE SHOWN AS MAXIMUM TO BE INSTALLED WIRES TO BE SIZED ACCORDING TO NAME PLATE DATA. IT SHALL BE PERMISSIBLE TO CHANGE CIRCUIT NO. WITHOUT CHANGING QUANTITY OF CIRCUITS.
- 13. ALL 120-VOLT, SINGLE-PHASE, 15- AND 20-AMPERE BRANCH CIRCUITS SUPPLYING OUTLETS INSTALLED IN DWELLING UNIT FAMILY ROOMS, DINING ROOMS, LIVING ROOMS, PARLORS, LIBRARIES, DENS, BEDROOMS, SUN ROOMS, RECREATION ROOMS, CLOSETS, HALLWAYS, OR SIMILAR ROOMS OR AREAS SHALL BE PROTECTED BY A LISTED ARC-FAULT CIRCUIT INTERRUPTER, COMBINATION-TYPE INSTALLED TO PROVIDE PROTECTION OF THE BRANCH CIRCUIT.
- 14. PADDLE FANS EXCEEDING 35 LBS. WITH OR WITHOUT ACCESSORIES SHALL BE SUPPORTED INDEPENDENTLY OF THE OUTLET BOX. (TYP.)
- 15. ALL 125 VOLT, 15 AND 20 AMPERE RECEPTACLES SHALL BE LISTED TAMPER RESISTANT IN DWELLING UNITS.
  16. A MINIMUM OF 50% OF THE LAMPS IN PERMANENTLY INSTALLED LIGHTING FIXTURES SHALL BE HIGH-EFFICACY LAMPS.

	TYPE: SQUARE "D" OR EQUIVALENT APPROVED  SERVICE: 150 A  VOLTAGE: 240/120 V  MOUNTING: SURFACE MOUNTED  MAIN BUS: 150 AMPS  NEUTRAL: 150 AMPS  MAINS: 150 AMPS  LOCATION: GARAGE													
	AMP.	POLE	TOTAL V.A.	WIRE	LOCATION	CKT.		CKT. NO.	LOCATION	WIRE	TOTAL V.A.	POLE	AMP.	
EXIST.	60	2	10,000	EX.	A.H.U.	1		2	¬ C.U.	EX.	(7,000)	2	40	EXIS
~~~	~~~	~~~		· · · ·		3	ļ —	4		<u> </u>				
NEW	60	2	11,800	6	WATER HEATER	5		6	DRYER	EX.	5,000	2	30	EXIS
EVIOT			0.000		DANCE (WACDOUND)	7		8	REFRIGERATOR	EX.	1,500		20	EXIS
EXIST.	50	2	8,000	EX.	RANGE (W/GROUND)	- 11	<u> </u>	12	GARBAGE DISPOSAL	EX.	750	- 1	20	EXIS
EXIST.	20		1,500	EX.	WASHER	13		14	DISHWASHER	EX.	1,200	<del>- i</del> -	20	EXIS
EXIST.	20	<del></del>	1,500	EX.	SMALL APPLIANCES	15		16	BATH RECEPTACLE	EX.	*	<del></del>	20	EXIS
EXIST.	20		1,500	EX.	SMALL APPLIANCES	17	<u> </u>	18	GRAL, LT & RECEPT.	EX.	*	1	15	EXIS
EXIST.	15	<u> </u>	*	EX.	GRAL. LT & RECEPT.	19	<b> </b>	20	GRAL. LT & RECEPT.	EX.	*	1	15	EXIS
EXIST.	15	i	*	EX.	GRAL. LT & RECEPT.	21	<del> </del>	22	GRAL, LT & RECEPT.	EX.	* .	1 1	15	EXIS
EXIST.	15	. 1	*	EX.	GRAL. LT & RECEPT.	23	}	24	GRAL. LT & RECEPT.	EX.	*	1	15	EXIS
EXIST.	15	1	*	EX.	GRAL, LT & RECEPT.	25	}—	26	GRAL. LT & RECEPT.	EX.	*	ı	15	EXIS
EXIST.	15	. 1	*	EX.	GRAL. LT & RECEPT.	27	]	28	GRAL. LT & RECEPT.	EX.	. *	. 1	15	EXIS
NEW	20	1111	1,200	12	MICROWAVE	29	]	30	SMALL APPLIANCES	12	1,500	11.	20	N
NEW	30	2	6,500	10	WASHER/DRYER [	- 31	<u> </u>	32	SMALL APPLIANCES	12	1,500	. 1	20	N
					L	33		34	BATH RECEPTACLE	12	*	1	20	NE
NEW	20	1	1,500	12	REFRIGERATOR	35	1	36	GRAL. LT & RECEPT.	14	*	1	15	NE
NEW	20	2	2,500	12	MINI-SPLIT A/C	37	ļ	38	GRAL. LT & RECEPT.	14	*		15	N
						39		40	LIFT	12	1,500	1	20	NE
					2	41	J	42						

	LEGEND
\$	WALL SWITCH I5A, I25V
<b> \$</b> <sup>3</sup>	3-WAY WALL SWITCH 15A, 125V
<b>₽</b>	DUPLEX RECEPTACLE OUTLET I5A, I25V
<b>₽</b>	SWITCHED DUPLEX RECEP. OUTLET I5A, I25V
0	DUPLEX FLOOR RECEPTACLE, I5A, I25V
Ю	SIMPLEX RECEPTACLE OUTLET I5A, I25V
•	SPECIAL RECEPTACLE OUTLET
ю	WALL MOUNTED LIGHTING FIXTURE
ф.	CEILING LIGHTING FIXTURE
0	JUNCTION BOX
	RECESSED CEILING LIGHTING
•	TELEPHONE JACK
TV	TELEVISION OUTLET
D D	FUSE OR DISCONNECT SWITCH
С	CHIME
<b>(E)</b>	CARBON-MONOXIDE SMOKE DETECTOR
SD	SMOKE DETECTOR
	EXHAUST FAN
	ELECTRICAL METER/MAIN
	ELECTRICAL PANEL
and the second	

UNDER-COUNTER LIGHTING

SERVICE SIZE = 150 AMPS


## ELECTRICAL LOAD CALCULATION

A - GENERAL LIGHTING LOAD: 2,262 S.F. @ 3 WATTS/S.F. = 6,786 WATTS B - FOUR SMALL APPLIANCE CIRCUITS X 1,500 WATTS = C - FIXED APPLIANCES: RANGE 8,000 WATTS <u>1,200</u> WATTS REFRIGERATOR 1,200 WATTS STACKABLE WASHER & DRYER 6,500 WATTS CLOTHES WASHER <u>1,500</u> WATTS CLOTHES DRYER 2 5,000 WATTS WATER HEATER (<u>ĬI,800</u>)WATTS 1,200 WATTS MICROWAVE MINI-SPLIT 2,500 WATTS GARBAGE DISPOSAL 750 WATTS CONNECTED LOAD LESS A/C = 52,436 WATTS FIRST 10,000 WATTS @ 100% = 10,000 WATTS 2

REST WATTS @ 40% = 16,974 WATTS

HEATING @ 65% = 8,125 WATTS

2 A/C @ 100% = 10,000 WATTS DEMAND LOAD= 35,099)240 WATTS= 146 AMPS @ 240/120 V

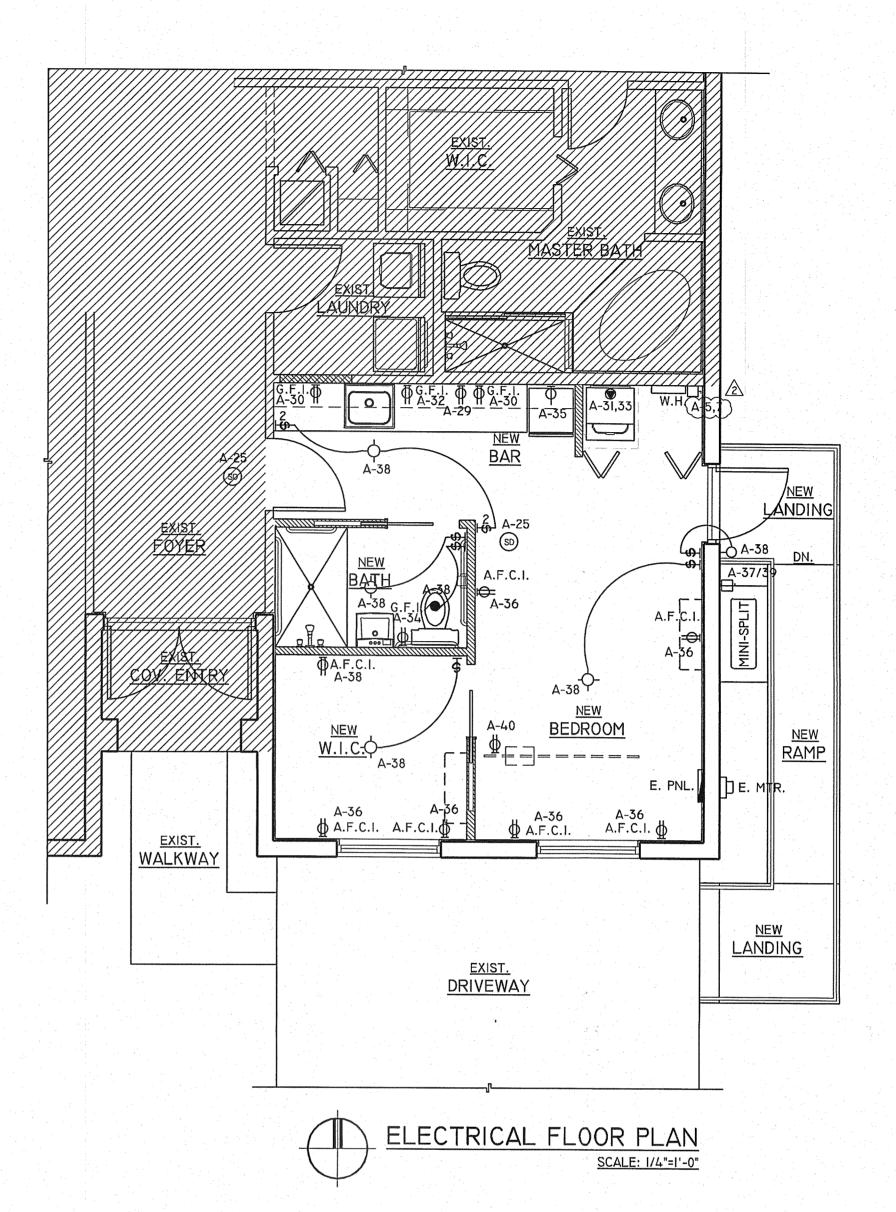

## SMOKE DETECTOR NOTES:

THERE ARE EXISTING SMOKE DETECTORS INSIDE AND OUTSIDE THE SLEEPING ROOMS

SCOPE OF REVISION:
WATER CHANGED FROM TANK TO INSTANTANEOUS WATER HEATER

CESAR M. CANO A.I.A.

ARCHITECTURE & PLANNING

REVISIONS

07/03/2015 (REV.) H.S.

07/17/2015

GARAGE CONVERSION
IN A RESIDENCE PROPERTY OF FRANK GA
LOCATED AT
16171 SW 151 TER, MIAMI, FL 33196

SCALE: AS SHOWN

DATE: 10/24/2014

JOB NO.

SHEET NO.:

E-I

Winds

Miami Dade County Department of Regulatory And Economic Resources 0000225664 - 7/24/2015 7:58:41 AM

E-1-07222015.PDF

<u>Examiner</u> <u>Date Time Stamp</u> <u>Disp. Trade</u> <u>Stamp Name</u> Victor Lombardi 7/24/2015 7:40:41 AMD ELEC Disapproved